NOAA
S 222

VENT CLOSURE

LOCATION	SYSTEM / SPACE SERVED
03-35-2 (WEATHER DECK)	SPLY 1-35-4 / A/C MACH, LAU RM, EMER GEN RM, BOW THR RM, FAN RM 1-34-2
03-35-4 (WEATHER DECK)	SPLY 1-35-4 / A/C MACH, LAU RM, EMER GEN RM, BOW THR RM, FAN RM 1-34-2
02-45-1 (WEATHER DECK)	SPLY 02-43-1 / PLTHS, SHIP OFC, UPR DK SR
01-12-2 (WEATHER DECK)	NATURAL SUPPLY, EMER GEN ROOM 01-6-0
01-12-3(2) (WEATHER DECK)	EXHAUST, EMER GEN RADIATOR
01-12-7 (WEATHER DECK)	NATURAL EXHAUST, EMER GEN RM
01-21-2 (WEATHER DECK)	EXHAUST, T/S 1-21-2
01-31-1 (WEATHER DECK)	NATURAL EXHAUST, HOSPITAL 1-29-1
01-32-1 (WEATHER DECK)	EXHAUST, T/S 1-31-1
01-44-1 (WEATHER DECK)	EXHAUST, GALLEY RANGE HOOD
01-66-1 (WEATHER DECK)	NATURAL EXHAUST, PLENUM
01-71-1 (WEATHER DECK)	NATURAL EXHAUST, FAN RM 1-67-1
01-73-1 (WEATHER DECK)	NATURAL EXHAUST, PRPLN MOTOR RM 3-52-0
01-73-2 (WEATHER DECK)	SUPPLY 3-71-2 / PRPLN MOTOR RM 3-52-0
1-72-1 (WEATHER DECK)	NATURAL EXHAUST, GENERAL WORKSHOP 1-62-1
1-72-2 (WEATHER DECK)	SUPPLY 3-71-2 / PRPLN MOTOR RM 3-52-0
1-75-1 (WEATHER DECK)	NATURAL SUPPLY, ARRAY WINCH SHOP HEAD
1-75-2 (WEATHER DECK)	NATURAL SUPPLY, WINCH MACHINERY ROOM
1-76-1 (WEATHER DECK)	NATURAL SUPPLY, ARRAY WINCH SHOP
1-78-1 (WEATHER DECK)	NATURAL EXHAUST, TUNNEL 3-72-1
1-79-2 (WEATHER DECK)	NATURAL EXHAUST, ARRAY WINCH SHOP & HEAD
1-79-4 (WEATHER DECK)	EXHAUST, WINCH MACHINERY ROOM
1-94-1 (WEATHER DECK)	SUPPLY 2-96-1 / STEERING GEAR RM 2-94-0
1-94-2 (WEATHER DECK)	NATURAL EXHAUST, STEERING GEAR RM 2-94-0

REVISIONS

REV	SHT	ZONE	ITEM	DESCRIPTION	DATE	APPD
F	ALL	ALL	1	REDRAWN TO INCORPORATE NEW ABS REQUIREMENTS.	02/06/06	
G	ALL	ALL	1	REDRAWN TO INCORPORATE NEW AND RELOCATED EQUIPMENT.	09/09/09	
H	ALL	ALL	1	REDRAWN TO INCORPORATE IMO RESOLUTION A.952(23) PER ABS REQUIREMENTS.	10/12/10	
J	2	13-C	1	UPDATED TO SHOW NEW COMPARTMENT CONFIGURATION AND ADDED FIRE LOCKER #5.	04/05/12	
	2	15-C	2	REVISED PORT FORWARD LIFERAFTS UPPER DECK FROM 25 MAN TO 20 MAN.		
	3	SHT 3	3	ADDED SHEET #3 TO SHOW LOCATIONS OF VENTILATION CLOSURES.		
				ALL THE ABOVE TO SUIT IMO RESOLUTION A.952(23) PER ABS REQUIREMENTS.		
K	ALL	ALL	1	UPDATED TO INCORPORATE FIRE PLAN REVIEW 2014.	05/16/14	
L	ALL	ALL	1	UPDATED TO SHOW NEW COMPARTMENT CONFIGURATION AND NEW AND RELOCATED EQUIPMENT.	08/02/17	

NATIONAL OCEANIC AND ATMOSPHERIC ADMINISTRATION
OFFICE OF NOAA CORPS OPERATIONS

ART ANDERSON ASSOCIATES
202 PACIFIC AVE, BREMERTON, WA 98337-1932
(360) 479-5600 FAX:(360) 479-5605

CONTRACT NO. AB133M-05-CQ-1044
TAR NO. AAA-011(02)
DSGN M. CAMPBELL 2/1/06
DWN M.CAMPBELL 2/1/06
CHK V. PARKER 2/3/06
CHK J. CARLSON 2/6/06
NOAA APPROVAL

NOAA SHIP THOMAS JEFFERSON

FIRE CONTROL PLAN

SIZE D | CAGE CODE 0YLJ5 | NOAA DRAWING NUMBER 985-6634639 | REV L
SCALE: AS SHOWN | CAD FILENAME 985-6634639_L | SHT 1 OF 3

THOMAS JEFFERSON - FIRE CONTROL PLAN

LEGEND

FIRE PLAN — FIRE CONTROL PLAN	C — CONTROL STATION	EMERGENCY TELEPHONE STATION	F — BELL FIRE ALARM	G — BELL GENERAL ALARM	FD — SPACE PROTECTED BY AUTOMATIC FIRE ALARM	H — HALON HORN	PRIMARY MEANS OF ESCAPE
CO_2 — CO2 RELEASE STATION	H — HALON RELEASE STATION	FOAM RELEASE STATION	CO_2 — CO2 BATTERY	H — HALON BATTERY	P — PORTABLE DRY CHEMICAL FIRE EXTINGUISHER	CO_2 — PORTABLE CO2 FIRE EXTINGUISHER	MANUALLY OPERATED CALL POINT
REMOTE CONTROLLED FUEL/LUBRICATING OIL VALVES	F — FIRE STATION	FIRE ALARM PANEL	F — AFFF HOSE REEL & HANDGUN	W — WATER FOG APPLICATOR	P — PORTABLE FOAM APPLICATOR	F — FOAM INSTALLATION	FIRE AXE
A — REMOTE VENTILATION SHUTOFF ACCOMMODATION AND SERVICES SPACES	C — REMOTE VENTILATION SHUTOFF CARGO SPACES	A — CLOSING APPLIANCE FOR EXTERIOR VENT INLET OR OUTLET ACCOMMODATION AND SERVICES SPACES	C — CLOSING APPLIANCE FOR EXTERIOR VENT INLET OR OUTLET CARGO SPACES	M — CLOSING APPLIANCE FOR EXTERIOR VENT INLET OR OUTLET MACHINERY SPACES	BREATHING APPARATUS SPARE	EMERGENCY ESCAPE BREATHING APPARATUS (EEBD)	LOCKER WITH ADDITIONAL PROTECTIVE CLOTHING
G — EMERGENCY GENERATOR	EMERGENCY SWITCHBOARD	FIRE PUMP	EMERGENCY FIRE PUMP (FIRE/BALLAST PUMP)	HEAT DETECTOR	VISUAL NOTIFICATION	24 — 24 V-DC SMOKE DETECTOR	INTERNATIONAL SHORE CONNECTION
A CLASS DIVISION	WT — A CLASS FIRE DOOR SELF-CLOSING	A CLASS FIRE DOOR SELF-CLOSING	A CLASS FIRE DOOR	B CLASS FIRE DOOR	B CLASS DIVISION	AUDIO/VISUAL DEVICE	A — FIRE DAMPER IN VENT DUCT ACCOMMODATION AND SERVICES SPACES
WT — REMOTE CONTROL WATERTIGHT DOOR	REMOTE CONTROLLED FIRE PUMPS OR EMERGENCY SWITCHES	REMOTE CONTROLLED FIRE PUMPS	REMOTE CONTROL BILGE PUMP VALVE	REMOTE CONTROL FIRE LUBE OIL VALVE	REMOTE CONTROL FIRE PUMP VALVE	REMOTE CONTROL FUEL OIL VALVE	C — CARGO SPACES FIRE DAMPER IN VENT DUCT
FL 1 — FIRE LOCKER 1 – DC LKR NO. 1 –2 FIREMANS OUTFIT CONSISTING OF: SELF CONTAINED BREATHING APPARATUS WITH 3 SPARE CHARGES, SAFETY BELT WITH LINE, PROTECTIVE CLOTHING, BOOTS, GLOVES, HELMET, LANTERN, AND FIRE-AXE, LIGHT FLOOR PORTABLE, AAAF INLINE EDUCTOR, NOZZLES, HACKSAWS SCREWDRIVERS, EXHAUST DE-SMOKER HOSE EXHAUST DE-SMOKER	FL 2 — FIRE LOCKER 5 – DC LKR NO.5 EMERGENCY EQUIPMENT LKR –2 FIREMANS OUTFIT CONSISTING OF: SELF CONTAINED BREATHING APPARATUS SAFETY BELT WITH LINE, PROTECTIVE CLOTHING, BOOTS, GLOVES, HELMET, LANTERN AND RADIO.	PUSH BUTTON/SWITCH GENERAL ALARM	FUEL PUMPS REMOTE SHUT-OFF	HALON — SPACE PROTECTED BY HALON	M — MACHINERY SPACES FIRE DAMPER IN VENT DUCT
FL 3 — FIRE LOCKER 3 – DC LKR NO. 3	FL 4 — FIRE LOCKER 4 – DC LKR NO. 4 AIR COMPRESSOR, CHARGES (3) SCBA (SELF CONTAINED BREATHING APPARATUS)	N — LITHIUM ION FIRE EXTINGUISHER	SUBMERSIBLE PUMP (RECEPTACLE)	M — REMOTE VENTILATION SHUTOFF MACHINERY SPACES	BREATHING DEVICE AIR COMPRESSOR		
ENGINE AND GENERATOR REMOTE EMERGENCY SHUTOFFS	F — FIXED FIRE EXTINGUISHING (WET CHEMICAL)	F — REMOTE RELEASE STATION (WET CHEMICAL)	UPS — UPS SHUTDOWN				

J1 L1

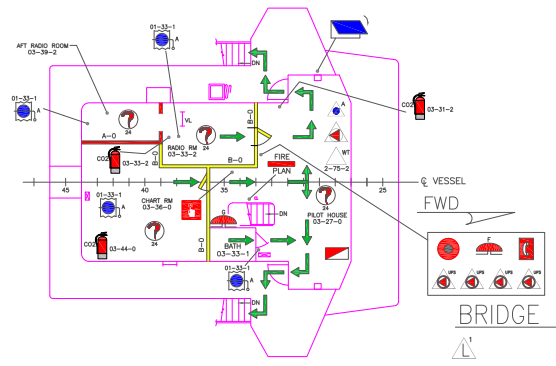

BRIDGE DECK

L1

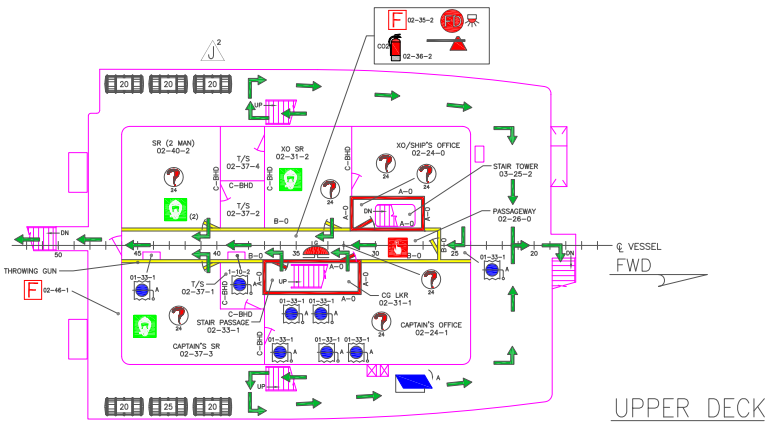

UPPER DECK

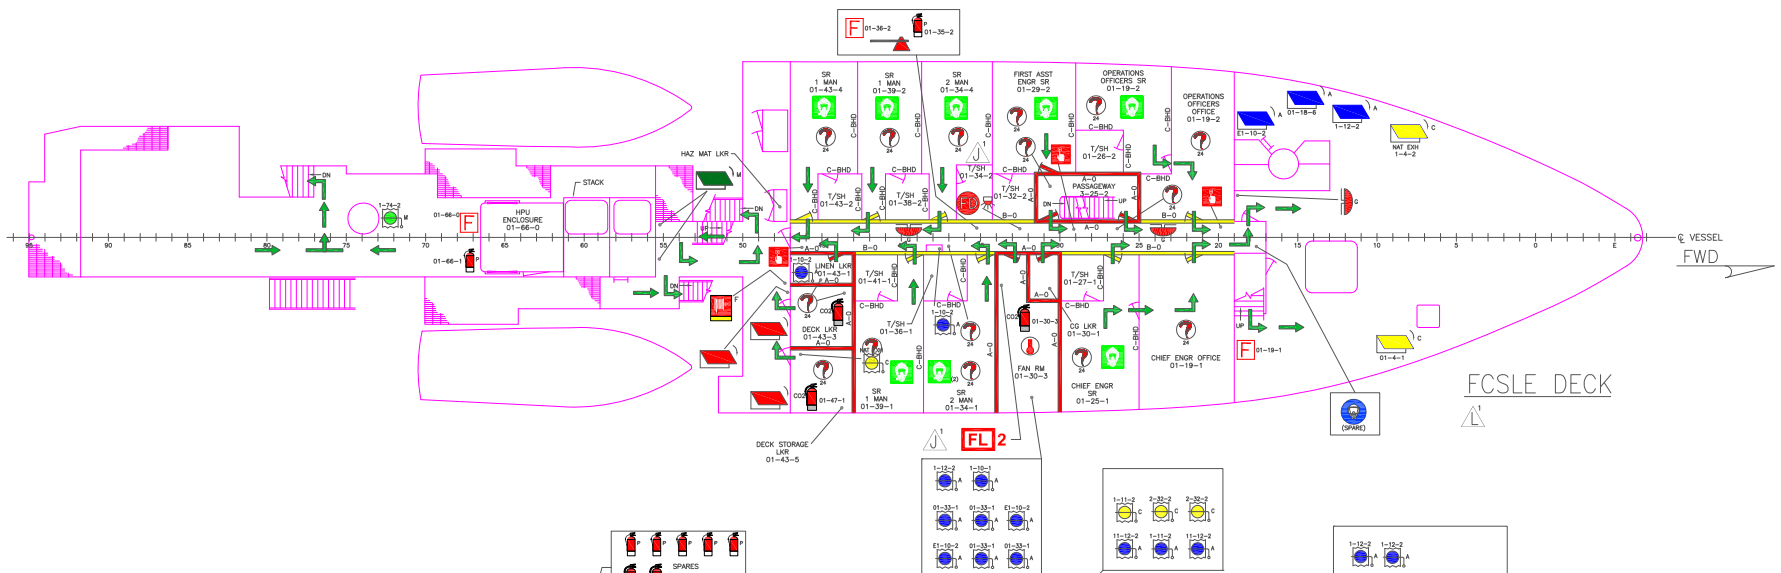

FCSLE DECK

L1

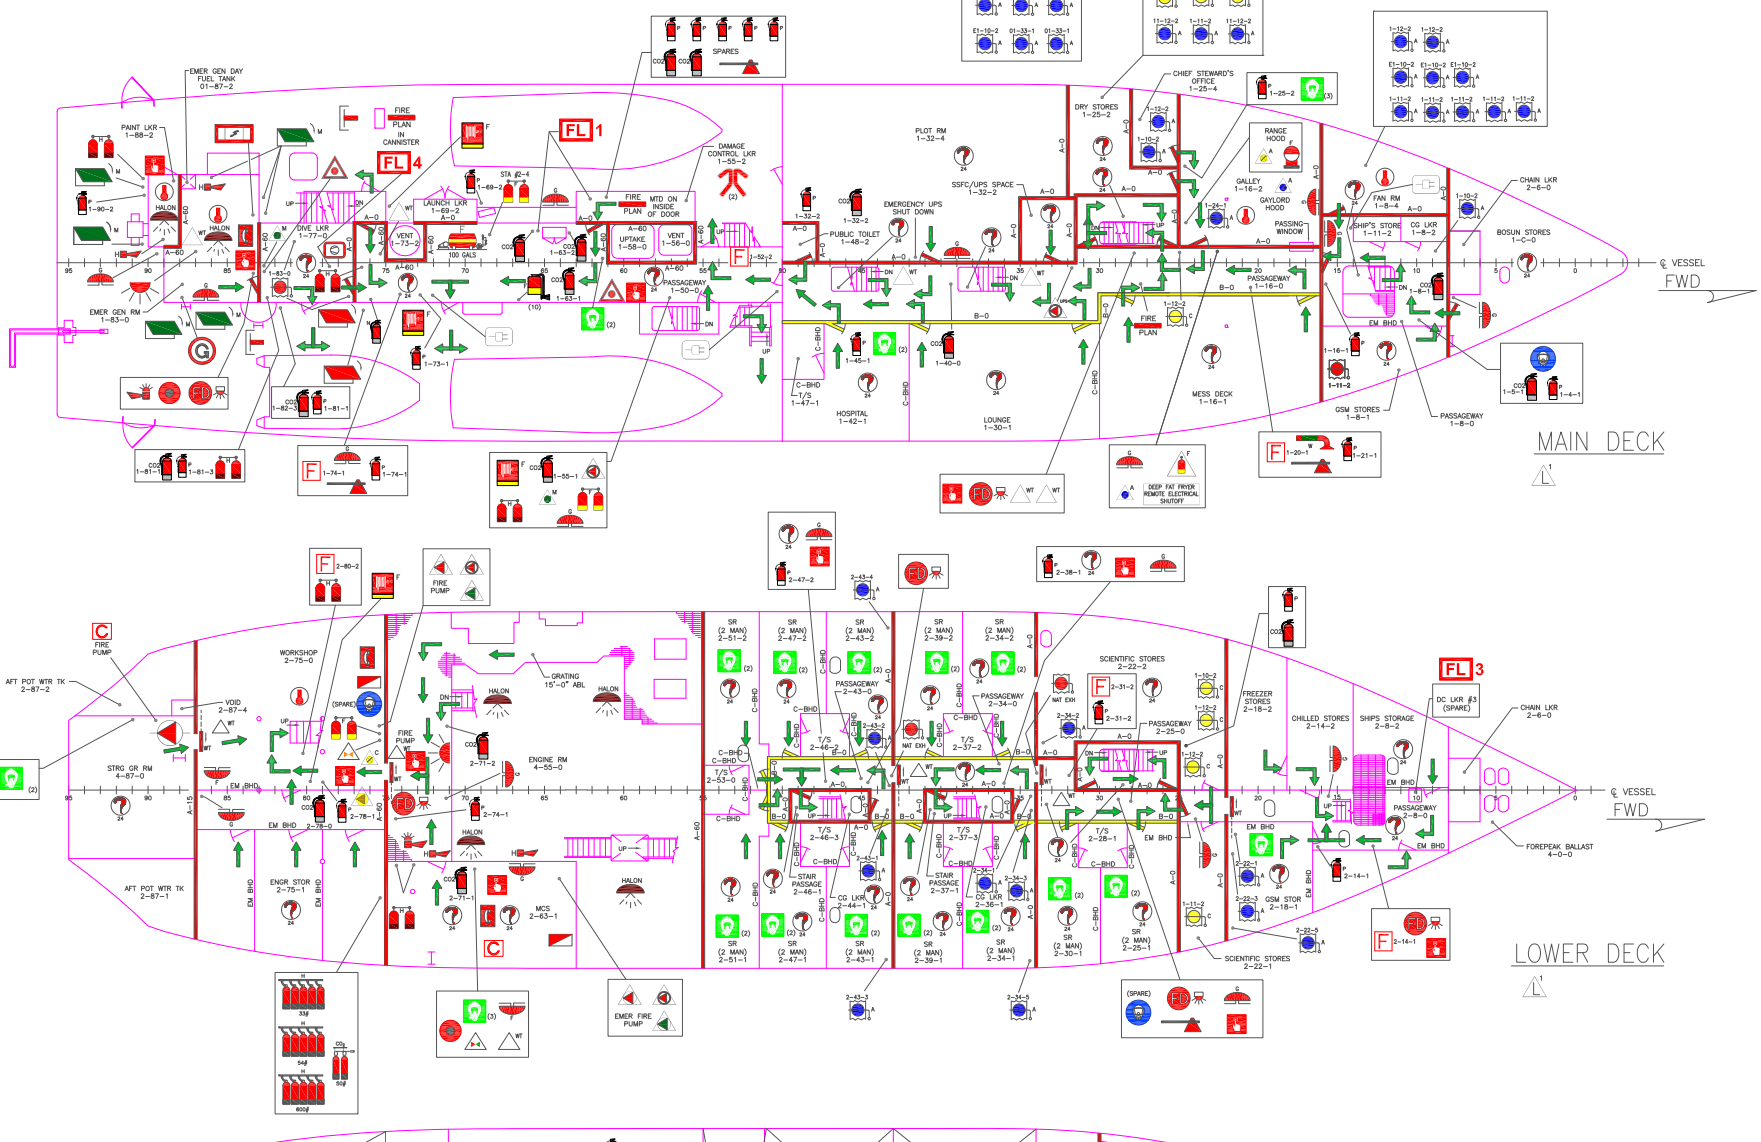

MAIN DECK

L1

LOWER DECK

L1

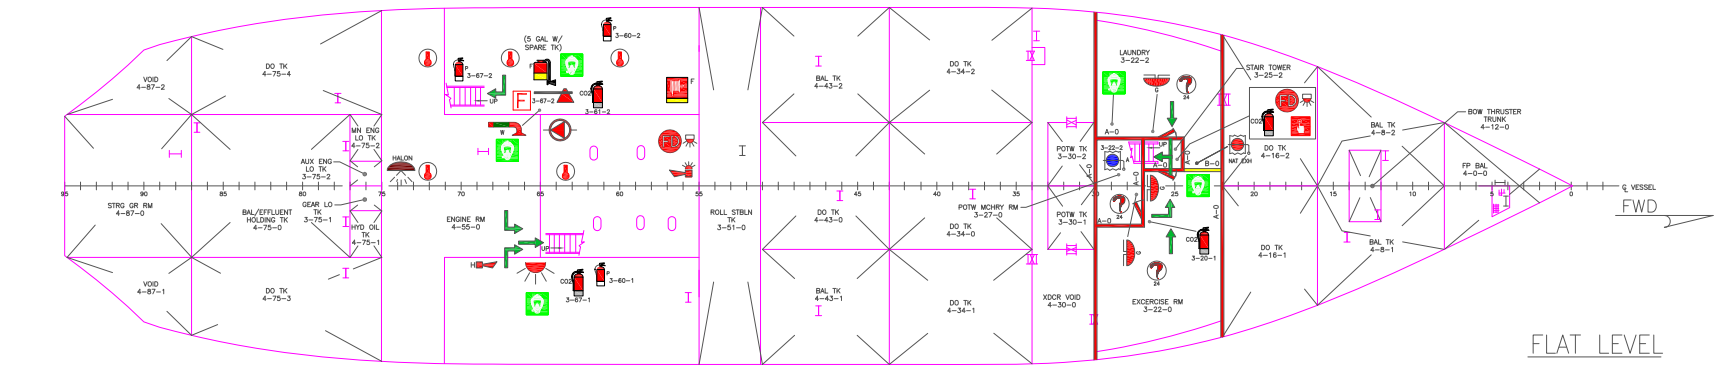

FLAT LEVEL

SIZE	CAGE CODE	NOAA DRAWING NUMBER	REV
D	OYLJ5	985-6634639	L

SCALE: NONE

CAD FILENAME 985-6634639_L SHT 2 OF 3

THOMAS JEFFERSON - FIRE CONTROL PLAN

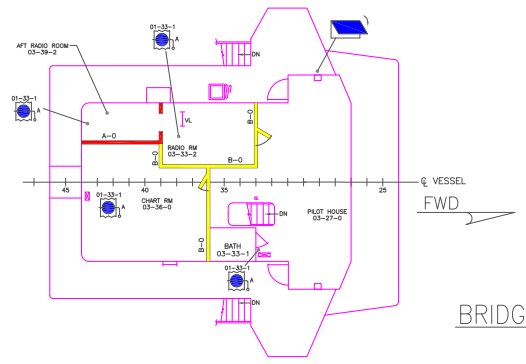

BRIDGE DECK

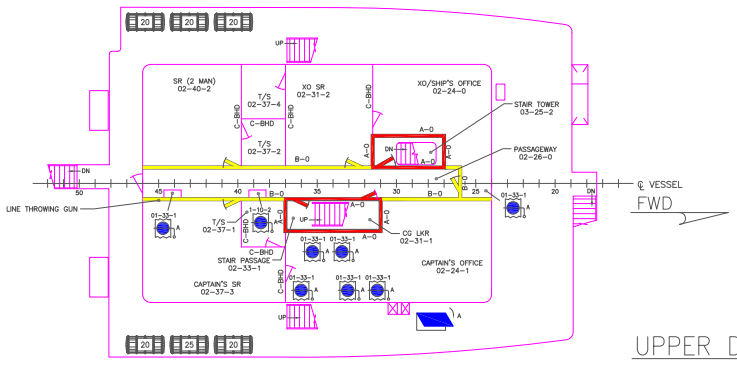

UPPER DECK

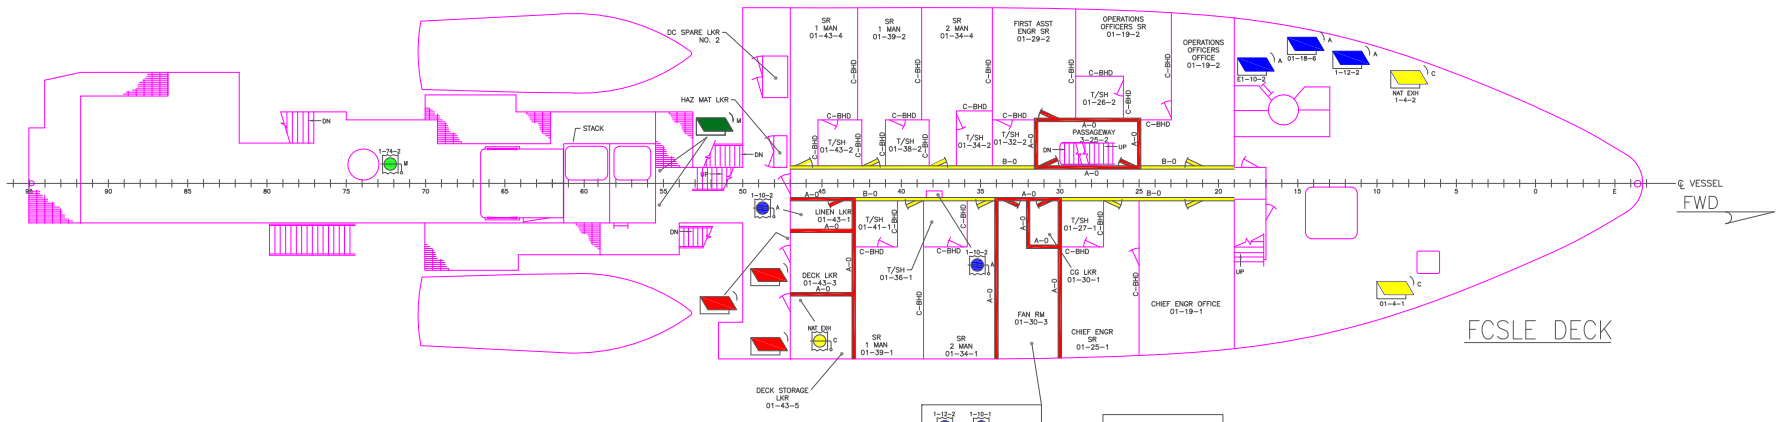

FCSLE DECK

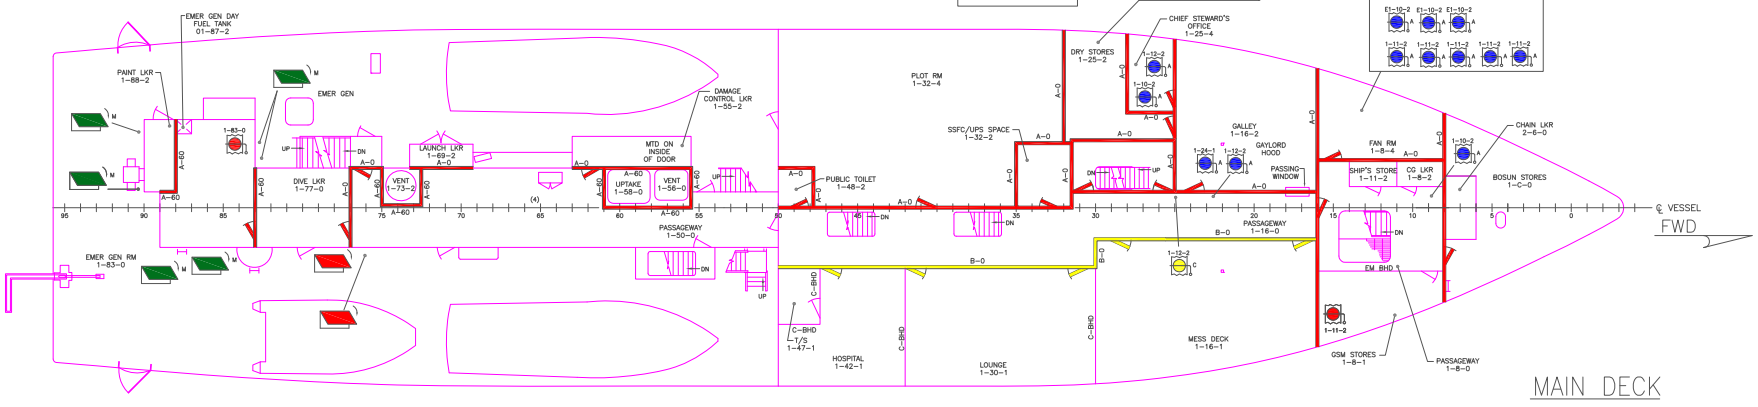

MAIN DECK

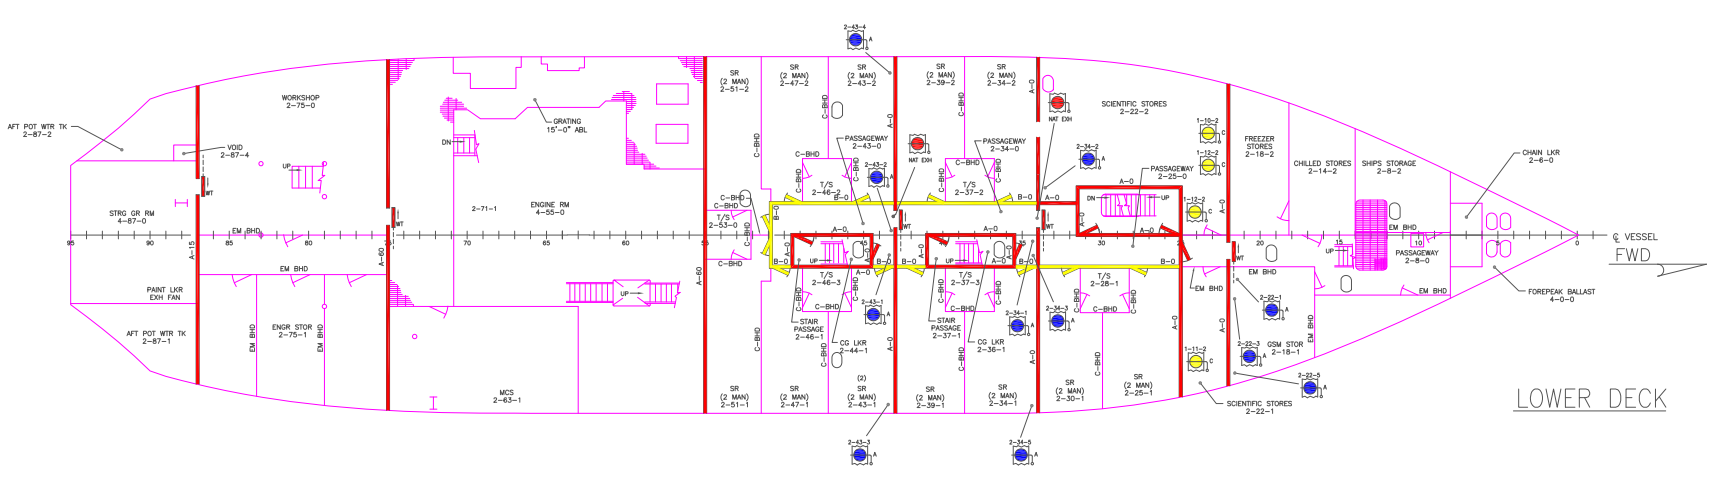

LOWER DECK

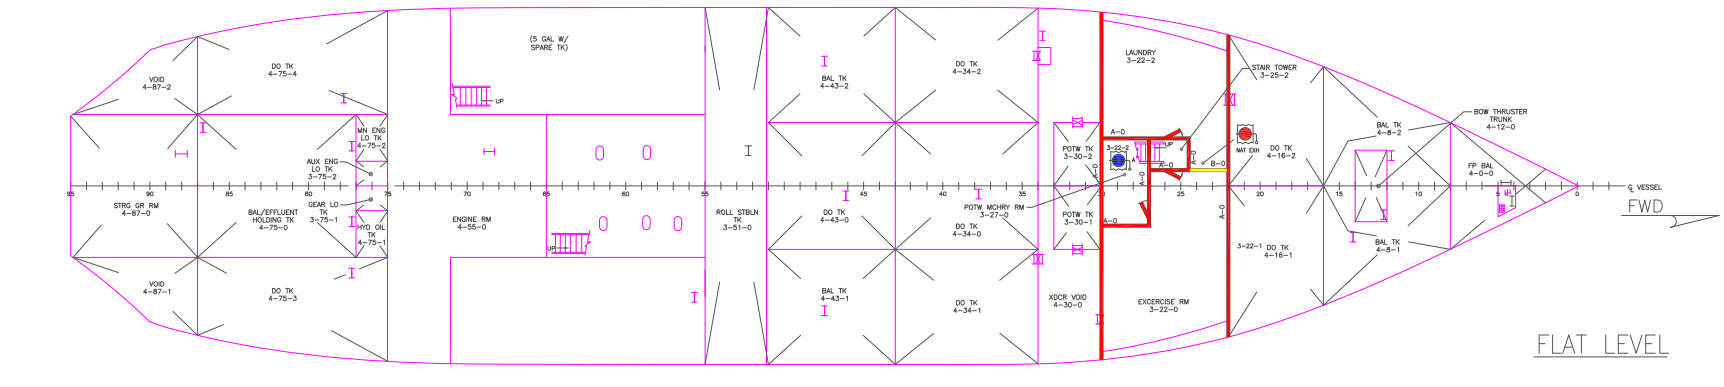

FLAT LEVEL

SIZE	CAGE CODE	NOAA DRAWING NUMBER	REV
D	OYLJ5	985-6634639	L

SCALE: NONE

CAD FILENAME 985-6634639_LI SHT 3 OF 3